As Laid Plan for Building Consent Number BC 230235

Owner Name: [redacted]

Project Location:

Street Number / Rural ID: _____ **Address:** _____

Locality: Lochmara

Plumber and Drainlayer Details:

Plumber: Morgan Plumbing **Registration Number:** 9979

Drainlayer: Morgan Plumbing **Registration Number:** 9979

Draw plan in ballpoint on graph section.

1. If drawing in colour use these:

   Sewer - red

   Stormwater - green

   Water - blue

Use these abbreviations:	
SS - Sanitary Sewer	IY - Inspection Y Junction
SW - Stormwater	IP - Inspection Pipe
GT - Gully Trap	AAV - Air Admittance Valve
TV - Terminal Vent	DP - Downpipe
BV - Back Vent	MH - Manhole
PV - Pan Vent	IC - Inspection Chamber
IB - Inspection Bend	BUS - Bubble Up Sump
	C - Cover

Plan is to show:

2. All drains in correct position relative to building and boundaries. Grade to be indicated.
3. All vents, gully traps and downpipes.
4. The road frontage
5. Depth of drains at connection points and key points such as top end, bottom end and inspections.
6. All foul water and stormwater drains.
7. All inspections opening points accurately dimensioned with at least two measurements.
8. All buildings and boundaries.
9. External main water lines and the source of supply.
10. North pointer or arrow.

Please refer to example on previous page as a guide to requirements.

Stone wall

Stone Wall

Location Pile fab

Location Pile fab

Stone Wall

Front Piles Approx locations

3m

1.8

By End Pile

2.5

1.9

Down from top Old Building

Stormwater Plan 2 of 3

6m

0.5m

7.8

100ϕ P.V.C Grade min 1:100

Heading towards Ammenities Block to collect then onto Creek

Power Cables buried with Stormwater

Office Use Only

Date of Inspection: _____

Plan Verification

Inspector's Name: _____

Inspector's Signature: _____

Office Use Only

Plan Verification

Date of Inspection: _____

Inspector's Name: _____

Inspector's Signature: _____

Stormwater Plan
1 of 3


Office Use Only

Date of Inspection: _____

Plan Verification

Inspector's Name: _____

Inspector's Signature: _____

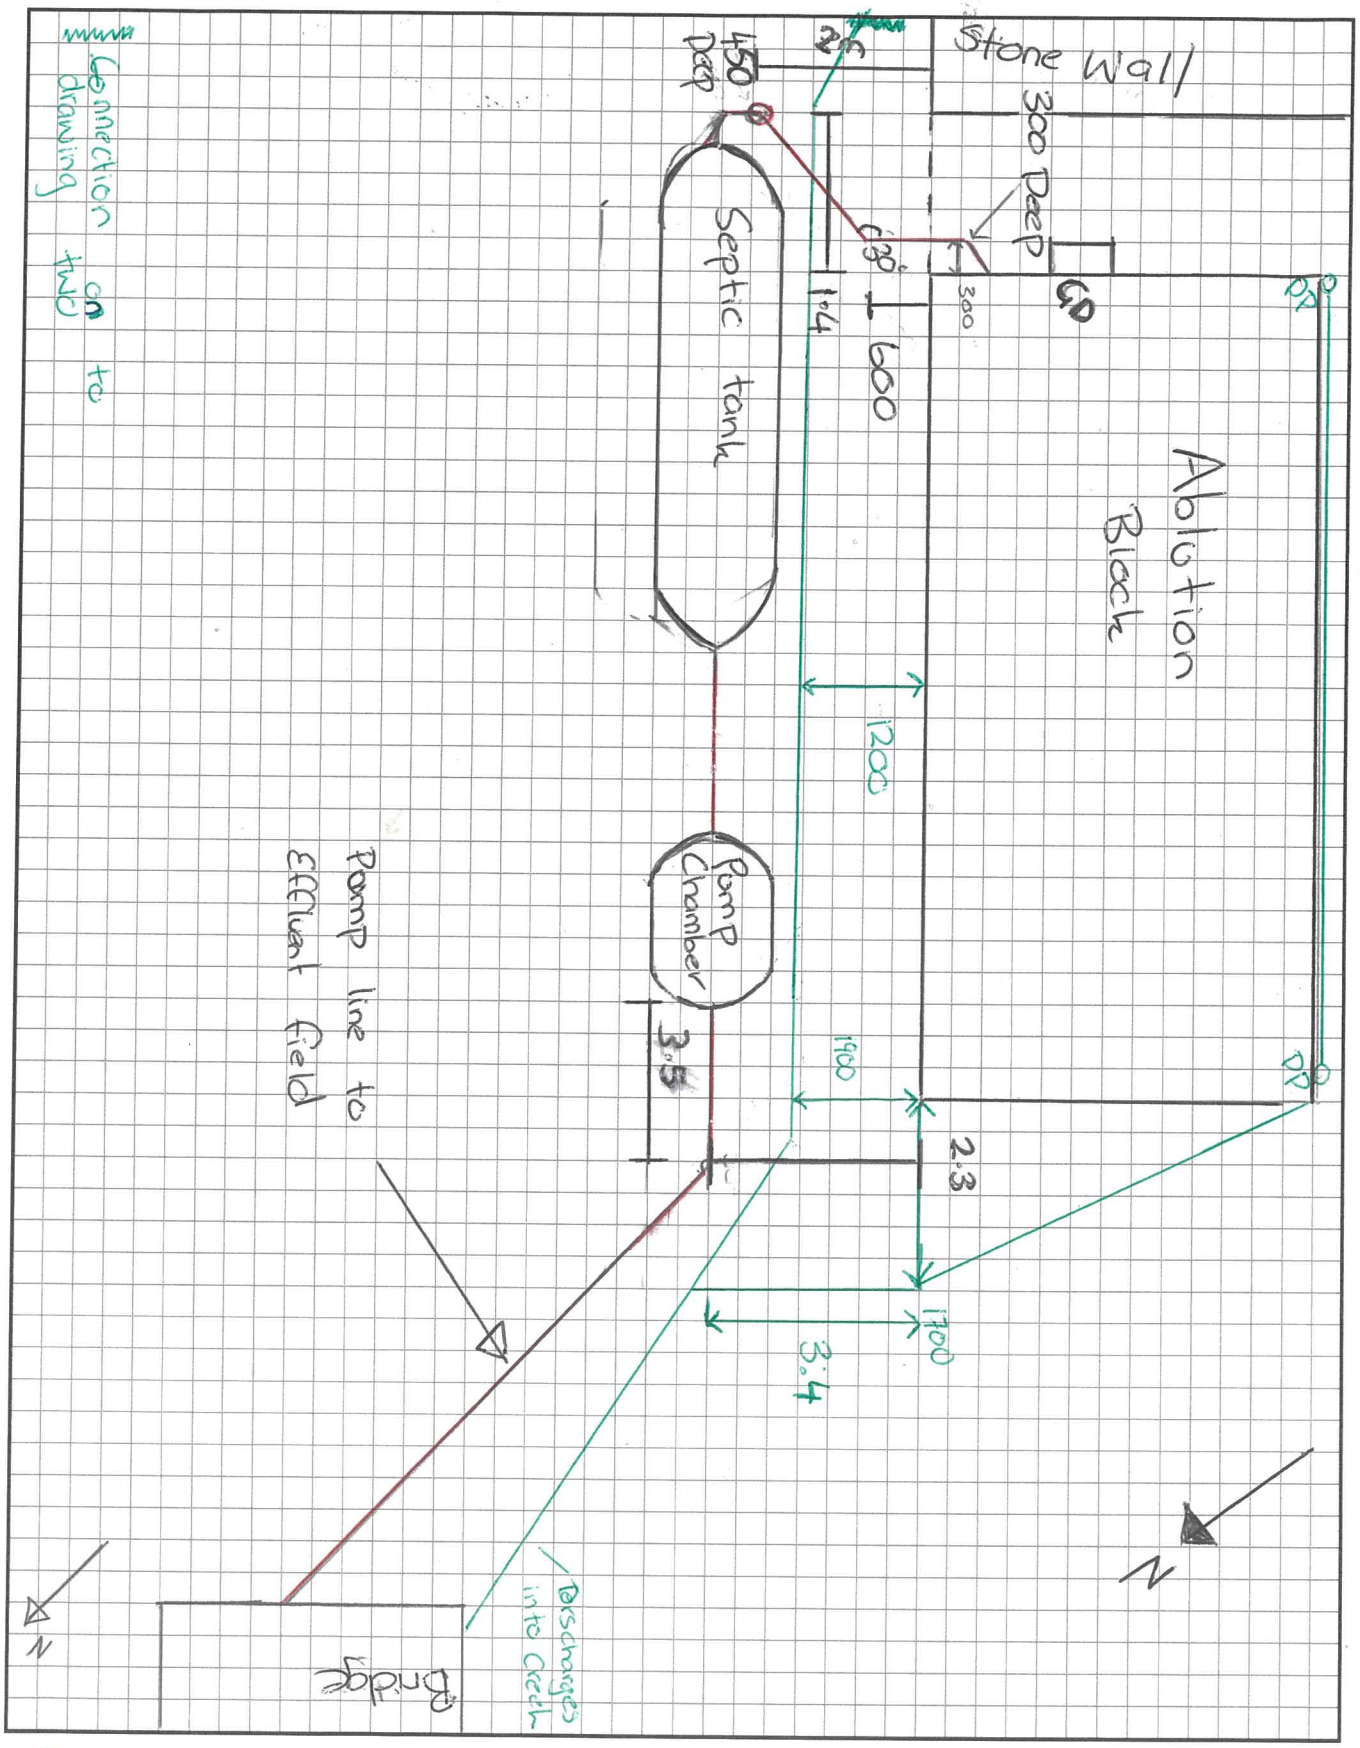

Office Use Only

Date of Inspection: _____

Plan Verification

Inspector's Name: _____

Inspector's Signature: _____

